


**PROFILE KINGS WAY**  
HOR. 1" = 40'  
VER. 1" = 8'

**CUL DE SAC PROFILE**

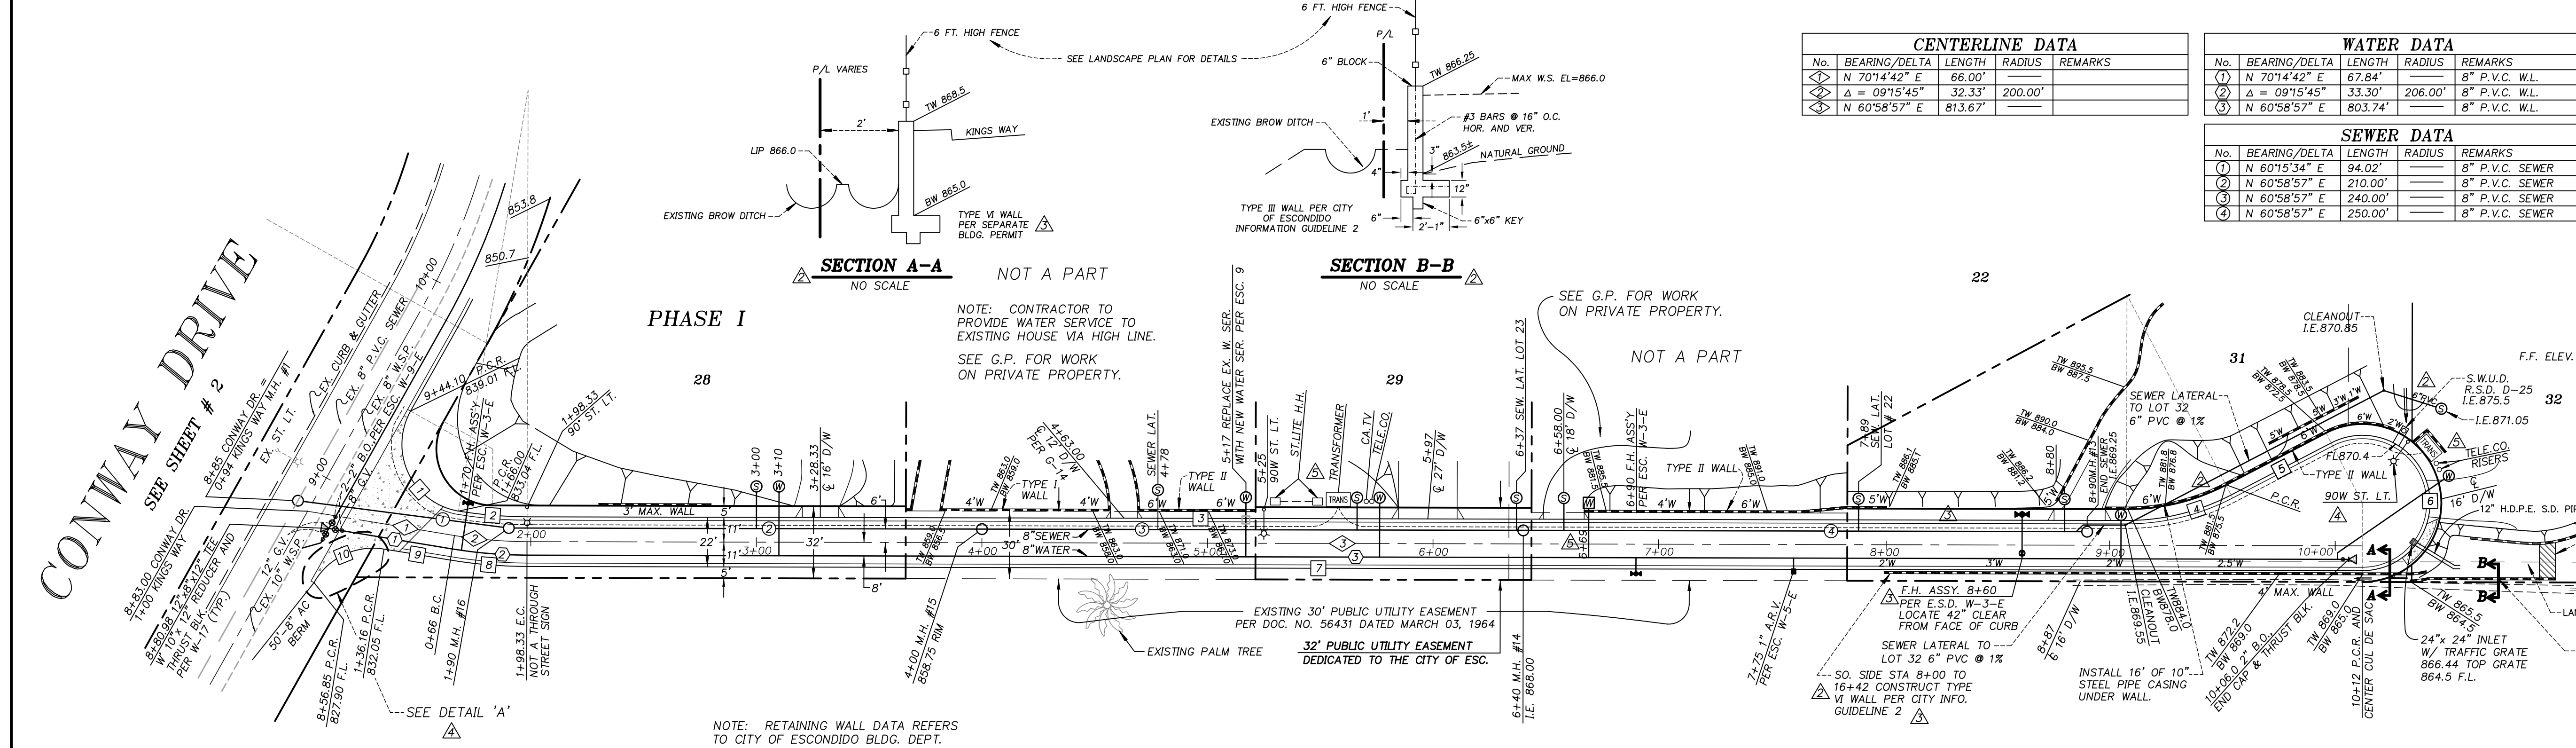


CENTERLINE DATA				
No.	BEARING/DELTA	LENGTH	RADIUS	REMARKS
1	N 70°14'42" E	66.00'		
2	Δ = 09°15'45"	32.33'	200.00'	
3	N 60°58'57" E	81.367'		

WATER DATA				
No.	BEARING/DELTA	LENGTH	RADIUS	REMARKS
1	N 70°14'42" E	67.84'		8" P.V.C. W.L.
2	Δ = 09°15'45"	33.30'	206.00'	8" P.V.C. W.L.
3	N 60°58'57" E	80.374'		8" P.V.C. W.L.

CURB DATA				
No.	BEARING/DELTA	LENGTH	RADIUS	REMARKS
1	Δ = 109°59'23"	57.60'	30.00'	6"-8" CURB & GUTTER
2	Δ = 09°15'45"	30.55'	189.00'	6" CURB & GUTTER
3	N 60°58'57" E	59.09'		6" CURB & GUTTER
4	Δ = 27°37'22"	48.21'	100.00'	6" CURB & GUTTER
5	N 33°21'35" E	50.00'		6" CURB & GUTTER
6	Δ = 207°37'22"	108.71'	30.00'	6" CURB & GUTTER
7	N 60°58'57" E	701.67'		6" CURB & GUTTER
8	Δ = 09°15'45"	34.11'	211.00'	6" CURB & GUTTER
9	N 70°14'42" E	29.84'		6" CURB & GUTTER
10	Δ = 70°00'00"	36.65'	30.00'	6"-8" CURB & GUTTER

SEWER DATA				
No.	BEARING/DELTA	LENGTH	RADIUS	REMARKS
1	N 60°58'57" E	94.00'		8" P.V.C. SEWER
2	N 60°58'57" E	210.00'		8" P.V.C. SEWER
3	N 60°58'57" E	240.00'		8" P.V.C. SEWER
4	N 60°58'57" E	250.00'		8" P.V.C. SEWER

NOTE: SEWER LATERAL TO LOT 32 LIES WITHIN UTILITY EASEMENT OVER LOT 31 PER RECORDED MAP NO. 12471

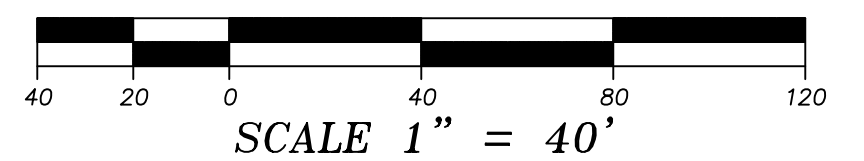

CONSTRUCTION RECORD		REFERENCES		DATE		BY		REVISIONS		APP'D		DATE	
Contractor								1	SEWER GRADES				
Inspector								2	WALL DETAILS				
Date Completed								3	Move F.H.#8+60, Delete wall				
								4	Add splash wall, Move st. light				
								5	Record Drawing				

UTILITIES MANAGER		DATE	
BY		DATE	

CITY OF ESCONDIDO DEPT. OF PUBLIC WORKS		DRAWING NO.	
PLANS FOR THE IMPROVEMENT OF ESCONDIDO TR.650: (PHASE II)			
KINGS WAY (PRIVATE STREET)		SHEET 6 OF 6	