


- PAVING CONSTRUCTION NOTES**
- (P01) CONCRETE CURB, PER SDRSD G-1.
  - (P02) CONCRETE WALK PAVEMENT, PER DETAIL 3 ON SHEET 11.
  - (P03) ISOLATION JOINT PER LANDSCAPE PLANS.
  - (P04) DRIVEWAY APPROACH PER CITY OF CARLSBAD STANDARD PLANS, GS-12.
  - (P05) THICKENED CONCRETE PAVING FOR AUTOMOBILE LOADING PER DETAIL 1, SHEET 11.
  - (P06) SECURITY FENCE PER LANDSCAPE PLANS.
  - (P07) CONCRETE MOW STRIP PER LANDSCAPE PLANS.
  - (P08) FILTRATION PLANTER PER UTILITY PLAN.
  - (P09) DECOMPOSED GRANITE PER LANDSCAPE PLANS.
  - (P10) INTERLOCKING PAVERS PER DETAIL 4, SHEET 11. OTHER DETAILS PER LANDSCAPE PLANS.
  - (P11) WATER FEATURE PER LANDSCAPE PLANS.
  - (P12) CONCRETE CURB AND GUTTER PER SDRSD G-2.
  - (P13) BBO PER LANDSCAPE PLAN.
  - (P14) 18"x18" CONCRETE STEPPING PADS PER LANDSCAPE PLANS.
  - (P15) DRIVEWAY CLOSURE, RAISE TO GRADE, SIDEWALK PER CITY OF CARLSBAD STANDARD.
  - (P16) COMMUNITY GARDEN PER LANDSCAPE PLANS.
  - (P17) TRANSFORMER PER ELECTRICAL PLANS.

SEE SHEETS 9 AND 10 FOR PUBLIC AND PRIVATE UTILITIES

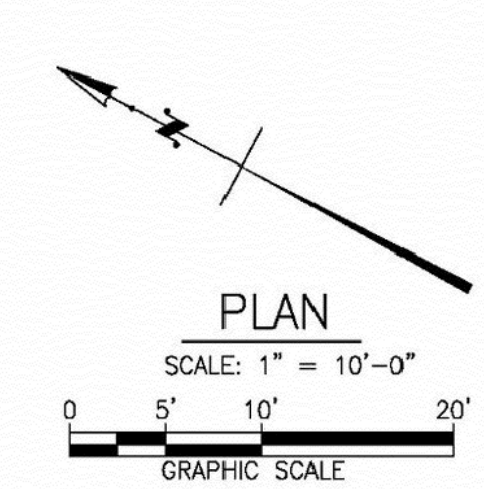

**"AS BUILT"**

RCE: \_\_\_\_\_ EXP: \_\_\_\_\_ DATE: \_\_\_\_\_

REVIEWED BY: \_\_\_\_\_

INSPECTOR: \_\_\_\_\_ DATE: \_\_\_\_\_

SHEET 6	CITY OF CARLSBAD ENGINEERING DEPARTMENT	SHEETS 14
GRADING PLANS FOR: <b>TAVARUA SENIOR APARTMENTS</b> 3585 HARDING ST., CARLSBAD, CA GRADING AND PAVING PLAN—WEST		
APPROVED: _____		GLEN K. VAN PESKI
SENIOR CIVIL ENGINEER PE 41204 EXPIRES 3/31/13 DATE: _____		
DWN BY: _____	PROJECT NO: SDP 06-12A	DRAWING NO: 473-2A
CHKD BY: _____		
RVWD BY: _____		

- GSI LEGEND**
- Afe** — ENGINEERED FILL PLACED UNDER THE PURVIEW OF THIS REPORT
  - Afu** — UNDOCUMENTED ARTIFICIAL FILL
  - Qcol** — QUATERNARY COLLUVIUM
  - Qt** — QUATERNARY TERRACE DEPOSITS, CIRCLED WHERE BURIED
  - — APPROXIMATE LOCATION OF GEOLOGIC CONTACT
  - X-39** — APPROXIMATE LOCATION OF FIELD DENSITY TEST
  - X-50FG** — APPROXIMATE LOCATION OF FINISH GRADE FIELD DENSITY TEST
  - 62.4** — APPROXIMATE ELEVATION OF BOTTOM OF REMEDIAL GRADING EXCAVATION

ALL LOCATIONS ARE APPROXIMATE  
This document or effie is not a part of the Construction Documents and should not be relied upon as being an accurate depiction of design.

**FIELD DENSITY TEST LOCATION MAP**

Plate 1

W.O.	DATE: 04/12	SCALE: 1" = 10'
------	-------------	-----------------